


Labor and Materials

1	Copper } Connection.....	3/4	\$ 3.20
	Lead }		
1	Curb } Cock Valve }	3/4 in.	\$ 1.00
		(T. S. & V.)	
1	Service Box } Short 3 1/2 x 4 1/2 }		\$ 1.30
	Old returned } Long 4 1/2 x 5 1/2 }		
		Buff. or Rdway	
9	Ft. } Copper } Pipe at.....	3/4 in.	\$ 1.98
		Galv. Iron	
		Cast Iron	
	Nipples.....	in. at.....	\$
	Bushings.....	to..... in. at.....	\$
	Red'g } Couplings.....	to..... in. at.....	\$
	Inc'g }		
	Union.....	in. at.....	\$
	Meter.....	in. at.....	\$
	Lbs. Br. Stone at.....		\$
	Lbs. Sand at.....		\$
	Bags Cement at.....		\$
	Paving Brick } Mack } at.....		\$
		Red	
		Asphalt	
	Lead Joints at.....		\$
	Leadite Joints at.....		\$
2	Hrs. Foreman at.....	6.25	\$ 1.25
	Hrs. Common Labor at.....		\$
8	Hrs. Common Labor at.....	4.00	\$ 3.25
	Hrs. Mason at.....		\$
	Hrs. Mason's Helper at.....		\$
	Hrs. Compressor at.....		\$
	Compensation Ins.....		\$ 12
yes	Trucking.....		\$ 1.00
yes	Builders' Use of Water.....		\$
Total \$			13.10

27-26
#60 Sanford St

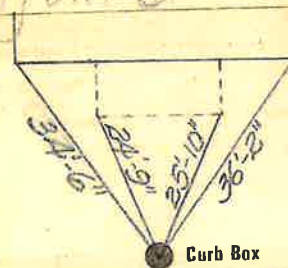

6" Main

Elev. of Main at tap 6'

Gate at TAX ID # 302.16-7-14 Gate at

● Curb Box

New House
9' to main
3/4" copper