

Labor and Materials

1	Copper	Connection.....	\$ 1.23	
	Lead			
1	Curb	Cock Valve T. S. & V. } 3/4 in.....	\$ 1.68	
1	Service Box	Short 3 1/2 x 4 1/2 }	\$ 1.75	
	Old returned	Long 4 1/2 x 5 1/2 }		
		Buff. or Rdway }		
23	Ft. 3/4 in.	Copper } Pipe at 15	\$ 3.45	
		Galv Iron }		
		Cast Iron }		
	Nipples	in. at	\$	
	Bushings	to	\$	
	Red'g	Couplings..... to	\$	
	Inc'g	in. at	\$	
	Union	in. at	\$	
	Meter	in. at	\$	
	Lead Joints	at	\$	
	Leadite Joints	at	\$	
	Hrs. Foreman	at	\$	
5	Hrs. Chauffeur	at 6.2 1/2	\$ 3.13	
9	Hrs. Tapper	at 7	\$ 5.67	
9	Hrs. Labor	at 7.5	\$ 40.5	
	Hrs. Labor	at	\$	
	Hrs. Compressor	at	\$	
	Compensation Ins.	\$ 39	
	Trucking	\$ 1.00	
	Builders Use of Water	\$	
	Tap by Wassell Patch -		\$ 5.00	
			\$	
			\$	
			\$	
			\$ 27.30	

38 - 1938


St. _____
Pl. _____
Ave: No. 77

Name of Owner

Wobb

Labor and Mat'l. Report

June 29 1938

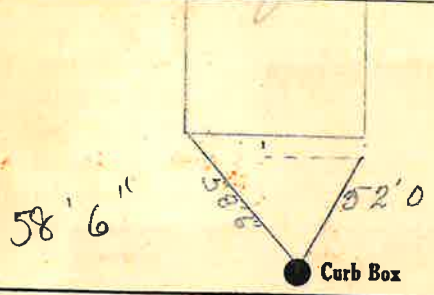

6 Main Elev. of Main at tap 5'

Gate at • TAX ID # 302.16-13-20 • Gate at

● Curb Box

23' to main
3/4" copper

N.W.

E.W.