

LABOR AND MATERIALS

1	Copper	{ Connection	$\frac{3}{4}$	\$	2.29
1	Lead				
1	Curb	{ Cock Valve	$\frac{3}{4}$ in.	\$	2.70
		{ T.S. & V.			
1	Service box	{ Short $3\frac{1}{2} \times 4\frac{1}{2}$		\$	4.25
	Old returned	{ Long $4\frac{1}{2} \times 5\frac{1}{2}$			
		{ Buff or Rdway			
22	Ft.	{ Copper	Pipe at	\$	7.70
	$\frac{3}{4}$ in.	{ G.I.			
		{ G.I.			
1	Nipples	$\frac{3}{4}$ in. at	Brass - 2" lg.	\$	
	Bushings	to	in. at	\$	
	Red'g	{ Coupl'gs	to	in. at	\$
	Inc'g				
	Union	in. at		\$	
	Meter	in. at		\$	
	Lead Joints	at		\$	
	Compound Joints	at		\$	
5	Hrs. Water Maint. Man-1	at	1.12	\$	5.60
2	Hrs. Water Maint. Man-2	at	1.07	\$	7.14
2	Hrs. Labor	at	91	\$	7.28
	Hrs. Labor	at		\$	
1	Hrs. Compressor	at		\$	1.20
	Compensation Ins. at \$	per C.		\$.45
	Trucking			\$	1.00
	Pav't Patch			\$	6.75
	Tap by Miller			\$	
	O'head			\$	
				\$	46.36

Revenue

75-150

Sanford


St. ~~PT~~
Ave. No. 79

Name of Owner

Philip Bentley

Labor and Mat'l. Report

Sept 5 19 50

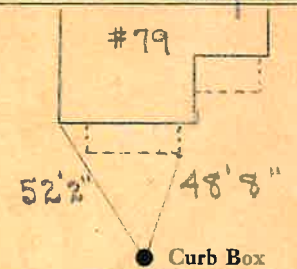

6" Main

Elev. of Main at tap 6'

Gate at ●

● Gate at

TAX ID # 302.16-13-19

● Curb Box

22' to main

$\frac{3}{4}$ " copper