

2 1941

Sanford


St. Pl. Ave. No. 85

Name of Owner

Ripley

Labor and Mat'l. Report

Dec 17 1940

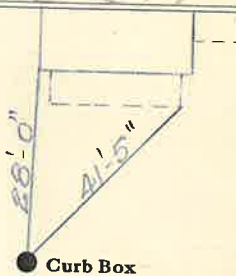

6 Main

Elev. of Main at tap 5

Gate at ●

● Gate at

● Curb Box

27' to main
3/4" copper

Sanford ST.


St. Pl. Ave. No. # 85

Name of Owner

TAX ID # 302.16-13-17

Labor and Mat'l. Report 19

3/16/18

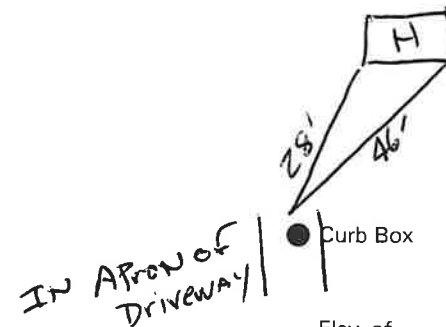

Main

Elev. of Main at tap

Gate at ●

● Gate at

● Curb Box

27' to main
3/4" copper

