


Labor and Materials

1	Copper	Connection	3	\$ 2.70
	Lead			
	Curb	Cock Valve T.S. & V.	3	\$ 2.39
	Service Box	Short 3/4 x 1/2		\$ 1.45
	Old returned	Long 1/2 x 3/4		
		Buff. or Rdway		
24	Ft.	Copper Galv. Iron Cast Iron	3	\$ 6.48
	Nipples	in. at		\$
	Bushings	to in. at		\$
	Red'g Inc'g	Couplings to in. at		\$
	Union	in. at		\$
	Meter	in. at		\$
	Lbs. Br. Stone	at		\$
	Lbs. Sand	at		\$
	Bags Cement	at		\$
	Paving Brick	Mack Red Asphalt at		\$
	Lead Joints	at		\$
	Leadite Joints	at		\$
4	Hrs.	Foreman at		\$ 2.50
14	Hrs.	Common Labor at		\$ 6.30
	Hrs.	Common Labor at		\$
	Hrs.	Mason at		\$
	Hrs.	Mason's Helper at		\$
	Hrs.	Compressor at		\$
	Compensation Ins			\$ 27
	Trucking			\$ 1 -
	Builders' Use of Water	Pitch		\$ 5 -
Total \$				28.09

Labor and Material Report

19

30-4
~~6787~~ Sanford

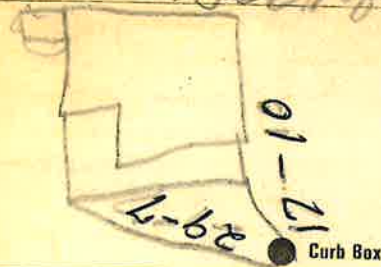

C Main Elev of Main at tap 53

Gate at TAX ID # 302.16-13-16 Gate at

● Curb Box

old tape
 dis com

24' to main

3/4" copper