


88 SANFORD St.
Pl. Ave. No.

Name of Owner
TAX ID # 302.16-8-9

Labor and Mat'l. Report 19

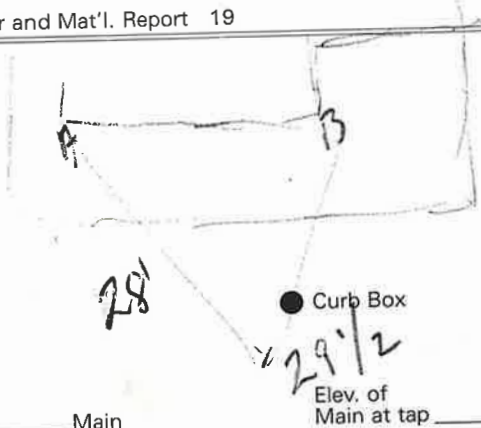


Gate at ● Main ● Gate at

OUTSIDE
CLEANOUT

● Curb Box

31-226
Labor and Material Report Nov. 5 1931

72 SANFORD ST.

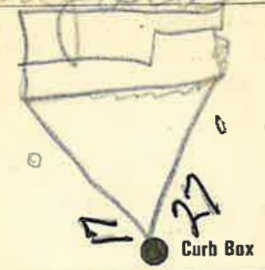

6 Main Elev. of Main at tap 5

Gate at ● TAX ID # 302.16-8-9 ● Gate at

● Curb Box

old taps dis-
connected.

10' to MAIN
3/4" COPPER

LABOR AND MATERIALS

Copper	} Connection		\$	
Lead				
Curb	} Cock Valve T.S. & V.	} in.	\$	
Service box	{ Short 3-1/2 x 4-1/2 Long 4-1/2 x 5-1/2 }		\$	
Old returned				
Ft.	{ Copper G.I. C.I. }	in. } Pipe at	\$	
Nipples			in. at	\$
Bushings		to in. at	\$	
Red'g				
Inc'g				
Union		in. at	\$	
Meter		in. at	\$	
			\$	
Compound Joints	at		\$	
Maintenance Foreman			\$	
Hrs. Water Maint. Man - 1	at		\$	
Hrs. Water Maint. Man - 2	at		\$	
Hrs. Garage Foreman	at		\$	
Hrs. Labor	at		\$	
Hrs. Compressor	at		\$	
			\$	
Trucking			\$	
Pav't Patch			\$	
			\$	
			\$	
			\$	
			\$	

Labor and Materials

Copper	} Connection		\$	
Lead				
Curb	} Cock Valve T.S. & V.	} in.	\$	
Service Box	{ Short 3 1/2 x 4 1/2 Long 4 1/2 x 5 1/2 Buff or Rd way }		\$	
Old returned				
10 Ft.	{ Copper Galv Iron Cast Iron }	in. } Pipe at	\$	
Nipples			in. at	\$
Bushings		to in. at	\$	
Red'g	} Couplings	to in. at	\$	
Inc'g				
Union		in. at	\$	
Meter		in. at	\$	
Lbs. Br. Stone	at		\$	
Lbs. Sand	at		\$	
Bags Cement	at		\$	
Paving Brick	{ Mack Red Asphalt }	} at	\$	
Lead Joints			at	\$
Leadite Joints	at		\$	
3 Hrs. Foreman	at		\$	1.88
7 Hrs. Common Labor	at		\$	3.15
Hrs. Common Labor	at		\$	
Hrs. Mason	at		\$	
Hrs. Mason's Helper	at		\$	
Hrs. Compressor	at		\$	
Compensation Ins.			\$	16
Trucking			\$	1
Builders' Use of Water			\$	5
Total \$				19.45