

Labor and Materials

1	Copper	} Connection.....	3/4	\$	1.75
	Lead				
1	Curb	} Cock Valve T.S.&V.	3/4 in	\$	1.70
1	Service Box	} Short 3 1/2 x 4 1/2 Long 4 1/2 x 5 1/2 Butt or Rdway		\$	1.45
	Old returned				
25	Ft.	} Copper Cast Iron Cast Iron	3/4 in	Pipe at	13 1/2 \$ 3.38
	Nipples		in. at	\$	
	Bushings		to	in. at	\$
	Red'g Inc'g	} Couplings	to	in. at	\$
	Union		in. at	\$	
	Meter		in. at	\$	
	Lbs. Br. Stone		at	\$	
	Lbs. Sand		at	\$	
	Bags Cement		at	\$	
	Paving Brick	} Mack Red Asphalt		at	\$
	Lead Joints			at	\$
	Leadite Joints		at	\$	
5	Hrs. Foreman		at	6 1/2	\$ 3.12
4	Hrs. Common Labor		at	50	\$ 2.00
12	Hrs. Common Labor		at	45	\$ 5.40
	Hrs. Mason		at		\$
	Hrs. Masons Helper		at		\$
	Hrs. Compressor		at		\$
	Compensation Ins				\$ 40
	Trucking				\$ 20
	Builders Use of Water	Patch			\$ 5


Total \$ 25.71

1935-27

Labor and Material Report

May 15 1935

69 Sanford St

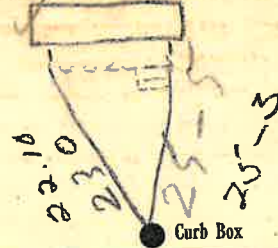

6 Main

Elev. of Main at tap 5

Gate at TAX ID # 302.16-13-15 Gate at

● Curb Box

old street at
main
25' to main
3/4" copper