


Labor and Materials

1	Copper } Connection.....	2	\$ 2.60
	Lead		
1	Curb } Cock } Valve } T. S. & V. } in.....	4 3	\$ 2.30
1	Service Box } Short 2 1/2 x 1 1/2 } Long 4 1/2 x 5 1/2 } Buff. or Rdway } Old returned }	2 1/2	\$ 1.50
11	Ft. in. } Copper } Galv. Iron } Pipe at.....	3	\$ 2.92
	Nipples..... in. at.....	4	\$
	Bushings..... to..... in. at.....		\$
	Red'g } Couplings..... to..... in. at.....		\$
	Inc'g }		
	Union..... in. at.....		\$
	Meter..... in. at.....		\$
	Lbs. Br. Stone at.....		\$
	Lbs. Sand at.....		\$
	Bags Cement at.....		\$
	Paving Brick } Mack } Red } Asphalt } at.....		\$
	Lead Joints at.....		\$
	Leadite Joints at.....		\$
5	Hrs. Foreman at.....	3.13	\$
8	Hrs. Common Labor at.....	3.25	\$
	Hrs. Common Labor at.....		\$
	Hrs. Mason at.....		\$
	Hrs. Mason's Helper at.....		\$
	Hrs. Compressor at.....		\$
	Compensation Ins.....	17	\$
	Trucking.....	1.00	\$
	Builders' Use of Water Patch.....	5.00	\$

Total \$ 21,87

29-154 Labor and Material Report Sept 30 1909

74 Sanford

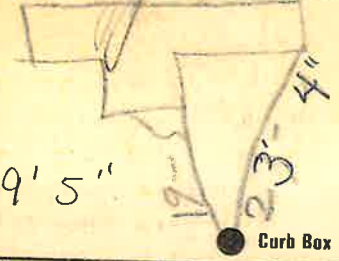

TAP ON Kenworthy Ave

4 Main Eley of Main at tap 4 1/2

Gate at TAX ID # 302.12-21-22 Gate at

Curb Box

old Tap to Box
shut off

11' to main
3/4" copper