


Labor and Materials

1	Copper	} Connection $\frac{3}{4}$ "	\$ 1.48
1	Lead			
1	Curb	} $\frac{3}{4}$ " in	\$ 1.79
	Cock Valve P.S.&V.			
1	Service Box	} Short $3\frac{1}{2} \times 4\frac{1}{2}$	\$ 1.30
	Old returned			
7	Ft. $\frac{3}{4}$ " in.	} Copper Galv. Iron Cast Iron	} Pipe at
	Nipples			
	Bushings to in. at	\$
	Red'g Inc'g	} Couplings to in. at
	Union			
	Meter in. at	\$	
	Lbs. Br. Stone	at	\$	
	Lbs. Sand	at	\$	
	Bags Cement	at	\$	
	Paving Brick	} Mack Red Asphalt	} at	\$
	Lead Joints			
	Leadite Joints	at	\$	
6	Hrs. Foreman	at	\$ 3.75	
6	Hrs. Common Labor	at Tapper	\$ 3.00	
	Hrs. Common Labor	at	\$	
	Hrs. Mason	at	\$	
	Hrs. Masons Helper	at	\$	
	Hrs. Compressor	at	\$	
	Compensation Ins	\$.21	
	Trucking	\$ 1.00	
	Builders Use of Water	at Patch	\$ 5.00	
Total				\$ 18.79

Labor and Material Report

Sept 26 1932

$\frac{3}{4}$ " tap at 76 Barbord at

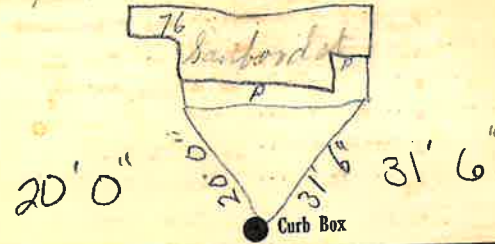

6" Main

Elev. of Main at tap 4 1/2'

Gate at TAX ID # 302.12-21-1

Gate at

● Curb Box

Old tap shut off

7' to MAIN
 $\frac{3}{4}$ " COPPER

Q/S (Signature)