

LABOR AND MATERIALS

1	Copper Lead	{ Connection	$\frac{3}{4}$	-----	\$ 1.35
1	Curb	{ Cock Valve	$\frac{3}{4}$	in. -----	\$ 1.88
		{ T. S. & V.			
1	Service Box Old returned	{ Short $3\frac{1}{2} \times 4\frac{1}{2}$ Long $4\frac{1}{2} \times 5\frac{1}{2}$ Buff. or Rdway		-----	\$ 1.82
24	Ft. $\frac{3}{4}$ in.	{ Copper Galv Iron Cast Iron		Pipe at 20	\$ 4.80
	Nipples	in. at -----			\$ -----
	Bushings	to ----- in. at -----			\$ -----
	Red'g Inc'g	{ Couplings	to ----- in. at -----		\$ -----
	Union	in. at -----			\$ -----
	Meter	in. at -----			\$ -----
	Lead Joints	at -----			\$ -----
	Leadite Joints	at -----			\$ -----
	Hrs. Foreman	at -----			\$ -----
14	Hrs. Chauffeur	at .6834			\$ 9.63
	Hrs. Tapper	at -----			\$ -----
12	Hrs. Labor	at .55			\$ 6.60
	Hrs. Labor	at -----			\$ -----
1	Hrs. Compressor	at -----			\$ 92
	Compensation Ins.	-----			\$ 50
	Trucking	-----			\$ 1-
	Builders Use of Water	Patch			\$ 5.00
	Toply Worsinsky				\$ -----
					\$ -----
					\$ -----
					\$ -----
					\$ -----
					\$ 33.50


4.

3 4 1942

St. Sanford
Pl. 95
Ave. No. 95

Name of Owner
Weaver

Labor and Mat'l. Report July 28 1942

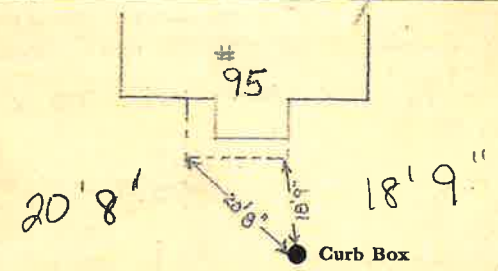

6 Main Elev. of Main at tap 5

Gate at ● Gate at ●

TAX ID # 302.16-13-12

● Curb Box
24' to MAIN
 $\frac{3}{4}$ " COPPER