

LABOR AND MATERIALS

1	Copper } Connection $\frac{3}{4}$		\$ 1.80	
	Lead }			
1	Curb { Cock Valve T. S. & V. }	$\frac{3}{4}$ in.	\$ 1.96	
1	Service Box Old returned	{ Short $3\frac{1}{2} \times 4\frac{1}{2}$ } { Long $4\frac{1}{2} \times 5\frac{1}{2}$ } { Buff for Rdway }	\$ 1.92	
24	Ft. $\frac{3}{4}$ in.	{ Copper Galv Iron Cast Iron } Pipe at 19	\$ 4.56	
	Nipples	in. at	\$	
2	Bushings $\frac{1}{2}$ "	to Flt. in. at	\$ 3.0	
	Red'g Inc'g } Couplings	to in. at	\$	
	Union	in. at	\$	
	Meter	in. at	\$	
	Lead Joints at		\$	
	Leadite Joints at		\$	
	Hrs. Foreman at		\$	
19	Hrs. Chauffeur at	.68 $\frac{3}{4}$	\$ 13.06	
	Hrs. Tapper at		\$	
	Hrs. Labor at		\$	
13	Hrs. Labor at	.60	\$ 7.80	
1	Hrs. Compressor at		\$.48	
	Compensation Ins.		\$.71	
	Trucking		\$ 1.00	
	Builders Use of Water		\$ 10.80	
	Top by Warsinski		\$	
			\$	
			\$	
			\$ 44.69	

38.44


Sanford

St. ~~Pl~~
Ave. No. 97

Name of Owner

Underwood

Labor and Mat'l. Report Nov 17 1944

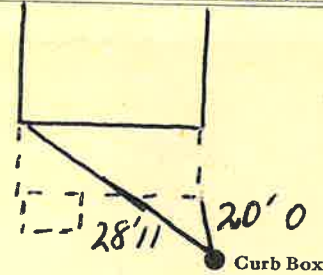

6 Main

Elev. of Main at tap 5

Gate at ●

● Gate at

TAX ID # 302.16-13-11

● Curb Box

24' to main
 $\frac{3}{4}$ " COPPER