

Labor and Materials


1	Copper	Connection	$\frac{3}{4}$ "	\$	3.20
1	Curb	Cock Valve	T.S. & V.	in.	\$ 1.00
1	Service Box	Short	3 1/2 x 4		\$ 1.20
	Old returned	Long	4 1/2 x 5		
		Buff. or Rdway			
9	Ft.	$\frac{3}{4}$ " in.	Copper Galv. Iron Cast Iron	Pipe at	\$ 19.8
	Nipples	in. at			\$
	Bushings	to in. at			\$
1	Red Iron	Couplings	to	in. at	\$ 1.5
	Union	in. at			\$
	Meter	in. at			\$
	Lbs. Br. Stone	at			\$
	Lbs. Sand	at			\$
	Bags Cement	at			\$
	Paving Brick	Mack Red Asphalt	at		\$
	Lead Joints	at			\$
	Leadite Joints	at			\$
7	Hrs. Foreman	at	6.25		\$ 2.50
26	Hrs. Common Labor	at	4.25		\$ 10.54
	Hrs. Common Labor	at			\$
	Hrs. Mason	at			\$
	Hrs. Mason's Helper	at			\$
	Hrs. Compressor	at			\$
	Compensation Ins.				\$.25
	Trucking				\$ 1.20
	Builders' Use of Water				\$

Total \$22.27

Labor and Material Report

May 19 1926

26 Sanford St

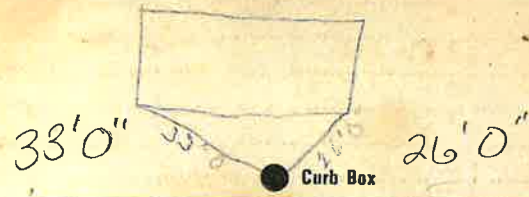

6 Main Elev. of Main at tap 94

Gate at TAX ID # 302.16-4-28 Gate at

Curb Box

new ground
new top
9' to MAIN
 $\frac{3}{4}$ " copper