

LABOR AND MATERIALS


1	Copper Lead	Connection	3/4"	\$
1	Curb	Cock Valve	3/4 in.	\$
		T.S. & V.		
1	Service box	Short 3 1/2 x 4 1/2		
	Old returned	Long 4 1/2 x 5 1/2		
		Buff or Rdway		\$
8	Ft. 3/4 in.	Copper G.I. C.I.	Pipe at	\$
	Nipples	in. at		\$
	Bushings	to in. at		\$
	Red'g Inc'g	Coupl'gs to in. at		\$
	Union	in. at		\$
	Meter	in. at		\$
	Lead Joints	at		\$
	Compound Joints	at		\$
	Maintenance Foreman			\$
	Hrs. Water Maint. Man-1	at		\$
	Hrs. Water Maint. Man-2	at		\$
	Hrs. Garage Foreman	at		\$
	Hrs. Labor	at		\$
	Hrs. Compressor	at		\$
	Compensation Ins.	at \$ per C.		\$
	Trucking			\$
	Pay't Patch			\$
				\$
				\$
				\$
	O'head			\$
				\$

Top by G. S. Ford & Co
July 10-22

Sanford ST St. Plr Ave. No. 100

Name of Owner Mc Nulty

Labor and Mat'l. Report July 10 1922

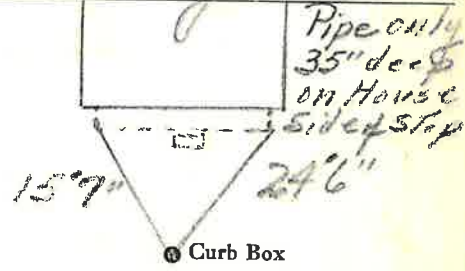

6" C.I. Main Elev. of Main at tap 5 1/2"

Gate at • Gate at

TAX ID # 302.12-22-15

• Curb Box

8' to MAIN
3/4" COPPER