

LABOR AND MATERIALS

1. Copper	Connection	3/4	\$ 2.87
Lead			
1. Curb	Valve	3/4 in.	\$ 3.62
	T. S. & V.		
1. Service box	Short 3 1/2 X 4 1/2		
Old returned	Long 4 1/2 X 5 1/2		\$ 4.68
	Buff or Rdway		
11. Ft.	3/4 in. Copper	Pipe at 32	\$ 3.52
	C.I.		
Nipples	in. at		\$
Bushings	to in. at		\$
Red'g			
Inc'g	Coupl'gs to in. at		\$
Union	in. at		\$
Meter	in. at		\$
Lead Joints	at		\$
Compound Joints	at		\$
Hrs. Water Maint. Man-1	at		\$
3 Hrs. Water Maint. Man-2	at 1.02		\$ 3.06
16 Hrs. Labor	at 91		\$ 14.56
Hrs. Labor	at		\$
Hrs. Compressor	at		\$
Compensation Ins.	at \$ 2.18 per C.		\$ 1.38
Trucking			\$ 2.00
Pav't Patch			\$ 10.25
Toply. Mfg. Union			\$
O'head			\$
			\$ 44.94

106

St.
 Pt.
 Ave. No. 106

Name of Owner


Hamel

Labor and Mat'l. Report

Oct 3

1949

SANFORD ST

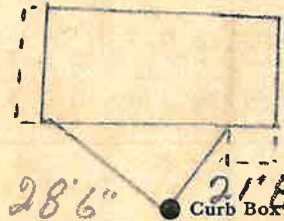

FLANDREAUX

4 Main

Elev. of Main at tap

5

Gate at ●

● Gate at

TAX ID # 302.12-23-2

● Curb Box

Tap on Flandreaux line
11' to MAIN
3/4" copper