

LABOR AND MATERIALS

1 Copper } Connection 3/4 \$ 2.94
 Lead }

1 Curb { Clock Valve } 3/4 in. \$ 3.71
 T.S. & V. }

1 Service box } Short 3 1/2 X 4 1/2 } Same \$ -
 Old returned } Long 4 1/2 X 5 1/2 }
 Buff or Rdway }

23 Ft. 3/4 in. { Copper } Pipe at 30 \$ 6.90
 Galv. Iron }
 Cast Iron }

..... Nipples in. at \$

..... Bushings to in. at \$

..... Red'g } Couplings to in. at \$
 Inc'g }

..... Union in. at \$

..... Meter in. at \$

..... Lead Joints at \$

..... Compound Joints at \$

..... Hrs. Foreman at \$

7 Hrs. Chauffeur at W.M.M.-2 91 \$ 6.37

..... Hrs. Tapper at \$

10 Hrs. Labor at 80 \$ 8.00 1737

..... Hrs. Labor at \$

1 Hrs. Compressor at 120 \$ 1.20

..... Compensation Ins. \$ 32

..... Trucking \$ 1.00

..... Builders Use of Water. Patch \$ 8.00

Taps 4 McGinnis \$

\$ 38.44

16


St. Sanford
 Pl. Ave. No. 109

Name of Owner

Laundry

Labor and Mat'l. Report

Apr 15 1948

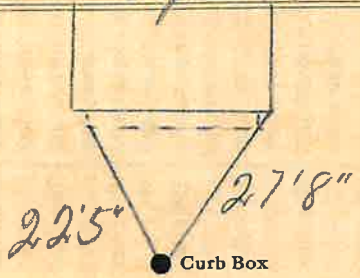

6 Main

Elev. of Main at tap 6

Gate at ●

● Gate at

TAX ID # 302.12-27-14

● Curb Box

23' to main
 3/4" copper