


### Labor and Materials

Copper	{	Connection.....				\$
Lead						
Curb	{	Cock Valve		in		\$
		T. S. & V.				
Service Box	{	Short 3½ x 4½				\$
Old returned		Long 4½ x 5½				
		Buff. or Rdway				
Ft. .... in.		Copper		Pipe at		\$
		Galv Iron				
		Cast Iron				
Nipples	in. at					\$
Bushings	to			in. at		\$
Red'g	{	Conplings.....		to		in. at
Inc'g						\$
Union	in. at					\$
Meter	in. at					\$
Lead Joints	at					\$
Leadite Joints	at					\$
Hrs. Foreman	at					\$
Hrs. Chauffeur	at					\$
Hrs. Tapper	at					\$
Hrs. Labor	at					\$
Hrs. Labor	at					\$
Hrs. Compressor	at					\$
Compensation Ins.						\$
Trucking						\$
Builders Use of Water						\$
						\$
						\$
St. Sanford  
 Pt. 112  
 Ave. No. 112

Name of Owner  
TAX ID # 302.12-24-10

Labor and Mat'l. Report 19

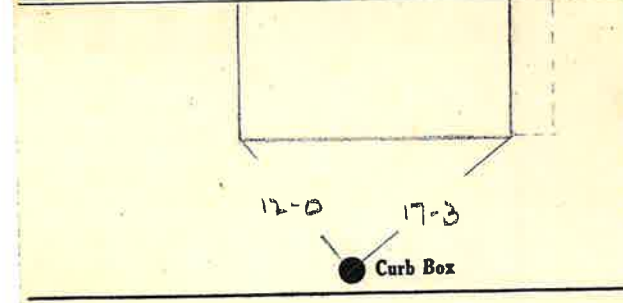

Elev. of Main at tap.....

Main FLANDREAUX

Gate at ● ● Gate at

● Curb Box