

Labor and Materials

1	Copper	} Connection.....	3	\$	1.43			
1	Lead							
1	Curb	} Cock Valve } T.S. & V. }	in	\$	1.88			
1	Service Box					} Short 3 1/2 x 4 1/2	\$	1.75
1	Old returned							
10	Ft. 3/4 in.	} Copper Galv. Iron } Pipe at	8 1/2	\$	1.80			
	Nipples					Cast-Iron		
	Bushings					to		
	Red'g Inc'g	} Conplings.....	to	in. at	\$			
	Union					in. at		
	Meter	in. at	\$					
	Lead Joints	at	\$					
	Leadite Joints	at	\$					
	Hrs. Foreman	at	\$					
2	Hrs. Chauffeur	at	\$	1.25				
4	Hrs. Tapper	at	\$	2.50				
4	Hrs. Labor	at	\$	1.80				
	Hrs. Labor	at	\$					
	Hrs. Compressor	at	\$					
	Compensation Ins.		\$	17				
	Trucking		\$	1.00				
	Builders Use of Water		\$					
	Hessel		\$					
	Patch		\$	5.00				
			\$					
			\$					
			\$	18.58				

3 1938


St.
Pt.
Ave. No. 112

Sanford

Name of Owner

Hemstreet

Labor and Mat'l. Report 4-21-38 19

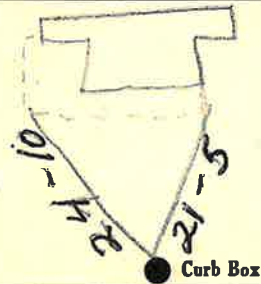

● Curb Box

6" Main

Elev. of Main at tap... 5

● Gate at

TAX ID # 302.12-24-11

● Gate at

● Curb Box

Old tap disconnected.

10' to MAIN

3/4" COPPER