


LABOR AND MATERIALS

1	Copper	} Connection	3/4	\$
	Lead			
1	Curb	} Cock Valve T.S. & V.	3/4 in.	\$
1	Service box	} Short 3 1/2 x 4 1/2 Long 4 1/2 x 5 1/2 Buff or Rdway		\$
	Old returned			
21'-6"	2 1/4 in.	} Copper G.I. G.I.	} Pipe at	\$
	Nipples	in. at	\$	
	Bushings	to in. at	\$	
	Red'g	} Coupl'gs	to in. at	\$
	Inc'g			
	Union	in. at	\$	
	Meter	in. at	\$	
	Lead Joints	at	\$	
	Compound Joints	at	\$	
	Maintenance Foreman		\$	
	Hrs. Water Maint. Man-1	at	\$	
	Hrs. Water Maint. Man-2	at	\$	
	Hrs. Garage Foreman	at	\$	
	Hrs. Labor	at	\$	
	Hrs. Compressor	at	\$	
	Compensation Ins.	at \$ per C	\$	
	Trucking		\$	
	Pav't Patch		\$	
			\$	
	Tap by Treceho + Co.		\$	
	July 15, 1979		\$	
	O'head		\$	
			\$	

St. Sanford
~~Pl.~~
~~Ave.~~ No. 115

Name of Owner Edward Carl

Labor and Mat'l. Report June 15, 1979

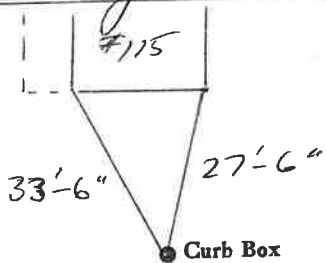

6" Main Elev. of Main at tap 5'
 Gate at • Gate at •

TAX ID # 302.12-27-11

• Curb Box
 21' 6" to MAIN
 3/4" COPPER