


### LABOR AND MATERIALS

1	Copper	} Connection	3/4			
	Lead				\$	
1	Curb	{ Clock Valve	3/4	in.		
		{ T.S. & V. }			\$	
1	Service box	}	Short 3 1/2 X 4 1/2			
	Old returned		Long 4 1/2 X 5 1/2			
			Buff or Rdway			\$
10	Ft.	}	Copper	Pipe at		
	3/4		Galv. Iron			
	in.		Cast Iron			\$
	Nipples		in. at		\$	
	Bushings		to	in. at	\$	
	Red'g	}	Couplings	to	in. at	
	Inc'g					\$
	Union		in. at		\$	
	Meter		in. at		\$	
	Lead Joints at				\$	
	Compound Joints at				\$	
	Hrs. Foreman at				\$	
	Hrs. Chauffeur at				\$	
	Hrs. Tapper at				\$	
	Hrs. Labor at				\$	
	Hrs. Labor at				\$	
	Hrs. Compressor at				\$	
	Compensation Ins.				\$	
	Trucking				\$	
	Builders Use of Water				\$	
					\$	
					\$	
St.  
Pl.  
Ave. No. 120

Name of Owner

Remeasured Oct 26-45  
Labor and Mat'l. Report June 18 19 27

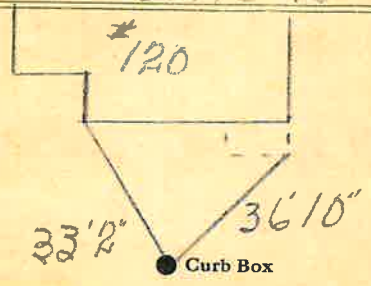

Main Elev. of Main at tap

Gate at ● ● Gate at

TAX ID # 302.12-13-1

● Curb Box

10' to main  
3/4" copper