

LABOR AND MATERIALS

1	Copper Lead	Connection	$\frac{3}{4}$		\$ 1.23
1	Curb	Cock Valve T. S. & V.	$\frac{3}{4}$	in.	\$ 1.68
1	Service Box	Short	$3\frac{1}{2} \times 4\frac{1}{2}$		\$ 1.54
	Old returned	Long	$4\frac{1}{2} \times 5\frac{1}{2}$		
		Buff. or Rdway			
23	Ft.	$\frac{3}{4}$ in.	Copper Galv-Iron Cast-Iron	Pipe at	\$ 3.91
	Nipples	in. at			\$
	Bushings	to in. at			\$
	Red'g Inc'g	Couplings	to in. at		\$
	Union	in. at			\$
	Meter	in. at			\$
	Lead Joints	at			\$
	Leadite Joints	at			\$
	Hrs. Foreman	at			\$
	Hrs. Chauffeur	at			\$
2	Hrs. Tapper	at	$6 \times \frac{1}{2}$		\$ 1.25
4	Hrs. Labor	at	$\frac{1}{4}$		\$ 2.50
4	Hrs. Labor	at	$\frac{4}{5}$		\$ 1.80
	Hrs. Compressor	at			\$
	Compensation Ins.				\$ 1.17
	Trucking				\$ 1.00
	Builders Use of Water				\$
	Tap by Hessel				\$
	Patrol - W. S. Dept.				\$ 2.50
					\$
					\$ 17.58

44 - - 1939

St.

Sanford

Pl.


Ave. No. 121

Name of Owner

Leonard Call

Labor and Mat'l. Report

July 12 1939

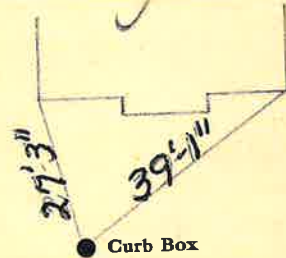

6 Main

Elev. of Main at tap 5

Gate at ●

● Gate at

TAX ID# 302.12-27-8

● Curb Box

23' to MAIN
3/4" COPPER

NEW TAP