


SANFORD, ST.

Labor and Material Report

June 16 1927

east of Cameron ave,

94 Sanford  
122

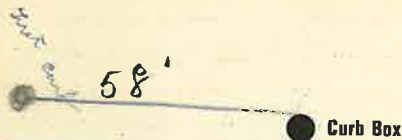

6" Main

Elev. of Main at tap 5'

Gate at ●

● Gate at

● Curb Box

measurement of  
secant tap

10' to main

3/4" copper

St.  
Pl.

Sanford St


Ave. No. 122

Name of Owner

Remeasured Oct 26-45

Labor and Mat'l. Report

June 16 1927

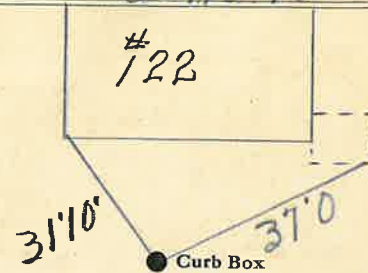

Main

Elev. of Main at tap

Gate at ●

● Gate at

TAX ID # 302.12-13-2

● Curb Box

10' to main

3/4" copper

