

8 4 - - 1939


St.  
Pl-  
Ave. No. 123

Sanford

Name of Owner

Cooley

Labor and Mat'l. Report Oct 7 1939

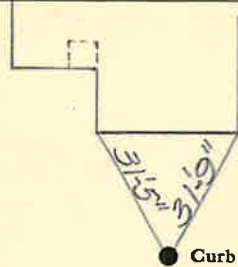

● Curb Box

6 Main

Elev. of Main at tap 5

Gate at ●

● Gate at

● Curb Box

22' to MAIN  
3/4" COPPER

New House

Labor and Material Report Aug 2 1928

1/2" tap at 42' east Sanford St



● Curb Box

6" Main

Elev. of Main at tap 3 1/2'

Gate at ●

● Gate at

TAX ID # 302.12-27-7

● Curb Box

22' to MAIN  
3/4" GAL

LABOR AND MATERIALS

1	Copper Lead	Connection	3/4	\$	1.23
1	Curb	Cock Valve T. S. & V.	3/4 in.	\$	1.68
1	Service Box Old returned	Short 3 1/2 x 4 1/2 Long 4 1/2 x 5 1/2 Buff. or Rdway		\$	1.54
22	Ft. 3/4 in.	Copper Galv. Iron Cast Iron	Pipe	at 17	\$ 3.74
	Nipples	in. at		\$	
	Bushings	to in. at		\$	
	Red'g Inc'g	Couplings	to in. at	\$	
	Union	in. at		\$	
	Meter	in. at		\$	
	Lead Joints	at		\$	
	Leadite Joints	at		\$	
	Hrs. Foreman	at		\$	
4	Hrs. Chauffeur	at 62 1/2		\$	2.50
6 1/2	Hrs. Tapper	at		\$	4.06
2	Hrs. Labor	at 45		\$	.90
	Hrs. Labor	at		\$	
	Hrs. Compressor	at		\$	
	Compensation Ins.			\$	23
	Trucking			\$	1-
	Builders Use of Water	Patch		\$	5-
	Tap by Messrs			\$	
	This hot had a tap but			\$	
	it was mag. had.			\$	
	it leaked.			\$	
				\$	21.88

Labor and Materials

1	Lead Connection		\$	1.91
1	Curb Cock		\$	1.16
1	Service Box Old returned	(Short 3 1/2 x 4 1/2) (Long 4 1/2 x 5 1/2) Buffalo		\$ 1.32
22	Ft. 3/4 in.	G. I. Pipe	at	\$ 7.64
	Nipples	in. at		\$
	Bushings	in. at		\$
	Red'g Coup	to in. at		\$
	Inc'g Coup	in. at		\$
	Union	in. at		\$
	Meter	in. at		\$
	Cu. Yds. Br. Stone	at		\$
	Cu. Yds. Sand	at		\$
	Bags Cement	at		\$
	Pav. Brick	(Mack Red Asphalt) at		\$
1	Hrs. Foreman	at		\$
1	Hrs. <del>Carpenter</del>	Penar		\$
	Hrs. Mason	at		\$
	Hrs.	at		\$
	Hrs.	at		\$
4	Builders' Use of Water			\$ 1.50
	Tracks	at		\$ 1.00
		at		\$
		at		\$
		at		\$
	Total			\$ 10.66