

### LABOR AND MATERIALS

Copper	}	Connection			\$
Lead					
Curb	}	Cock Valve T. S. & V.			\$
Service Box	}	Short 3/2x4 1/2 Long 4 1/2x5 1/2 Buff. or Rdway			\$
Old returned					
Ft. _____ in.	}	Copper Galv Iron Cast Iron			\$
Nipples					\$
Bushings					\$
Red'g Inc'g	}	Couplings			\$
Union					\$
Meter					\$
Lead Joints					\$
Leadite Joints					\$
Hrs. Foreman					\$
Hrs. Chauffeur					\$
Hrs. Tapper					\$
Hrs. Labor					\$
Hrs. Labor					\$
Hrs. Compressor					\$
Compensation Ins.					\$
Trucking					\$
Builders Use of Water					\$
					\$
					\$
St.

Pl


*Sanford*

Ave. No. *139*

Name of Owner

Labor and Mat'l. Report

19 *12*

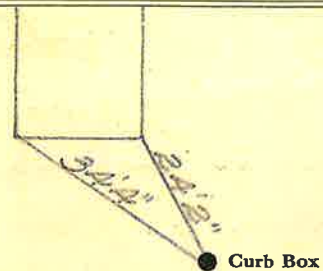

Main	Elev. of Main at tap
Gate at ●	● Gate at

● Curb Box