

### LABOR AND MATERIALS

1	Copper Lead	} Connection $\frac{3}{4}$		\$ 1.35
1	Curb	{ Cock Valve T. S. & V. }	$\frac{3}{4}$ in.	\$ 1.80
1	Service Box Old returned	{ Short $3\frac{1}{2} \times 4\frac{1}{2}$ Long $4\frac{1}{2} \times 5\frac{1}{2}$ Buffer Rdway }		\$ 1.70
23	Ft. $\frac{3}{4}$ in.	{ Copper Galv Iron Cast Iron }	Pipe at 18	\$ 4.14
	Nipples	..... in. at		\$
	Bushings	..... to ..... in. at		\$
	Red'g Inc'g	} Couplings..... to ..... in. at		\$
	Union	..... in. at		\$
	Meter	..... in. at		\$
	Lead Joints at			\$
	Leadite Joints at			\$
	Hrs. Foreman at			\$
	Hrs. Chauffeur at			\$
7	Hrs. Tapper at	6.2 1/2		\$ 4.38
7	Hrs. Labor at	4.5		\$ 3.15
	Hrs. Labor at			\$
1	Hrs. Compressor at	6.2 1/2		\$ 6.3
	Compensation Ins.			\$ .23
	Trucking			\$ 5.00
	Builders Use of Water	Patch		\$ 5.00
	Tap by Hassel			\$
				\$
				\$
				\$
				\$ 23.38

85 1941

St.  
Ave. No. 143


Sanford

Name of Owner

Bakst

Labor and Mat'l. Report

Sept 4 19 41

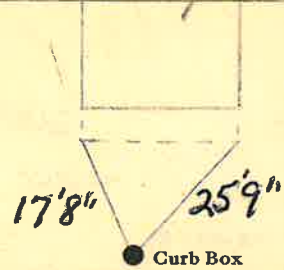

6

Main

Elev. of  
Main at tap. 5'

Gate at ●

● Gate at

TAX ID# 303.9-12-5

● Curb Box

23' to main

$\frac{3}{4}$ " copper