

LABOR AND MATERIALS

Copper	} Connection		\$	
Lead				
Curb	} Cock } Valve } T. S. & V.	in.	\$	
Service box		} Short 3½ x 4½ } Long 4½ x 5½		
Old returned				\$
Ft. 17'3"	} Copper } G.I. } G.P.	Pipe at	\$	
Nipples		in. at	\$	
Bushings	to	in. at	\$	
Red'g Inc'g	} Coupl'gs	to	in. at	
Union		in. at	\$	
Meter	in. at	\$		
Compound Joints	at	\$		
Maintenance Foreman		\$		
Hrs. Water Maint. Man-1	at	\$		
Hrs. Water Maint. Man-2	at	\$		
Hrs. Garage Foreman	at	\$		
Hrs. Labor	at	\$		
Hrs. Compressor	at	\$		
Trucking		\$		
Pav't Patch		\$		
		\$		
		\$		
SANFORD


St. Pt. Ave. No. 144

Name of Owner

VEYSEY

Labor and Mat'l. Report

19 85

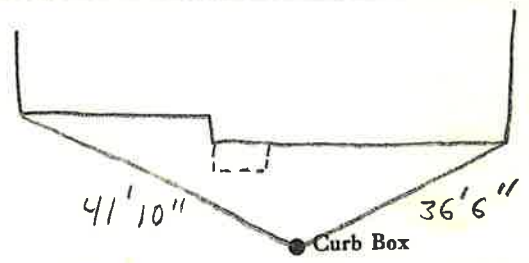

Main Elev. of Main at tap

Gate at • Gate at
#142 TAX ID # 3039-10-16

• Curb Box

17'3" to MAIN

No 144 on map, but 142