

### LABOR AND MATERIALS

1	Copper	Connection	\$ 1.23	
	Lead			
1	Curb	Cock Valve T-S. & V. $\frac{3}{4}$ in.	\$ 1.68	
1	Service Box	Short $3\frac{1}{2} \times 4\frac{1}{2}$	\$ 1.54	
	Old returned	Long $4\frac{1}{2} \times 5\frac{1}{2}$ Buff. or Rdway		
10	Ft. $\frac{3}{4}$ in.	Copper Galv-iron Cast-iron	Pipe at 17 \$ 1.70	
	Nipples	in. at	\$	
	Bushings	to in. at	\$	
	Red'g Inc'g	Couplings to in. at	\$	
	Union	in. at	\$	
	Meter	in. at	\$	
	Lead Joints	at	\$	
	Leadite Joints	at	\$	
	Hrs. Foreman	at	\$	
2	Hrs. Chauffeur	at $62\frac{1}{2}$	\$ 1.25	
7	Hrs. Tapper	at	\$ 4.38	
	Hrs. Labor	at	\$	
	Hrs. Labor	at	\$	
	Hrs. Compressor	at	\$	
	Compensation Ins.		\$ 18	
	Trucking		\$ 1-	
	Builders Use of Water		\$	
	Tape by Messrs		\$	
	Patch (1/2 Sewer Dept)		\$ 2.50	
			\$	
			\$	
			\$ 15.46	


7 8 - - 1939

St. \_\_\_\_\_  
Pl. \_\_\_\_\_  
Ave. No. 148

Sanford

Name of Owner \_\_\_\_\_

Labor and Mat'l. Report Sept. 21 1939

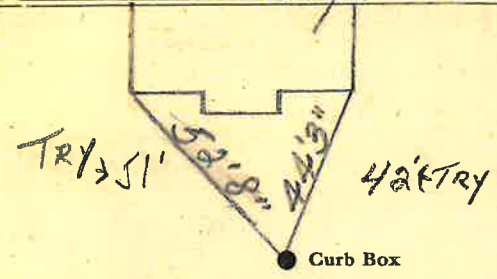

6" Main Elev. of Main at tap 5'

Gate at ● ● Gate at

TAX ID # 303.9-10-18

10' to MAIN ● Curb Box  
3/4" COPPER  
NEW HOUSE

*SH*