

### LABOR AND MATERIALS


1	Copper Lead	Connection	3/4	\$	1.59	
1	Curb	Clock Valve F.S. & V.	3/4 in.	\$	2.74	
1	Service box Old returned.	Short 3 1/2 X 4 1/2 Long 4 1/2 X 5 1/2 Buff or Rdway		\$	1.82	
22	Ft.	3/4 in.	Copper Galv. Iron Cast Iron	Pipe at	19 \$ 4.18	
	Nipples	in.	at	\$		
	Bushings	to	in.	at	\$	
	Red'g Inc'g	Couplings	to	in.	at	\$
	Union	in.	at	\$		
	Meter	in.	at	\$		
	Lead Joints	at	\$			
	Compound Joints	at	\$			
1	Hrs. Foreman	at W.W.M.	27	\$	7.77	
12	Hrs. Chauffeur	at	68 3/4	\$	8.25	
7	Hrs. Tapper	at		\$	4.81	
12	Hrs. Labor	at	60	\$	7.20	
	Hrs. Labor	at		\$		
3	Hrs. Compressor	at	87 1/2	\$	2.63	
	Compensation Ins.			\$	.56	
	Trucking			\$	1.00	
	Builders Use of Water		2	\$	9.00	
	Lap by Mog...					
				\$		
				\$		
				\$		
				\$		
				\$	44.55	

2

15 45 ✓  
St. Sanford  
Pl. Ave. No. 31

Name of Owner  
William Casey

Labor and Mat'l. Report Aug 27 1945

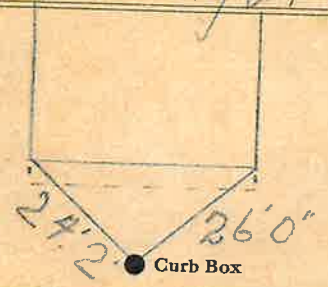

6" Main Elev. of Main at tap 6

Gate at ● Gate at

TAX ID # 302.16-11-14

● Curb Box

22" to main  
3/4" copper