

46-54

152?

Sanford


St. Pl. Ave. No. 154

Name of Owner

De Meo

Labor and Mat'l. Report

July 6 19 54

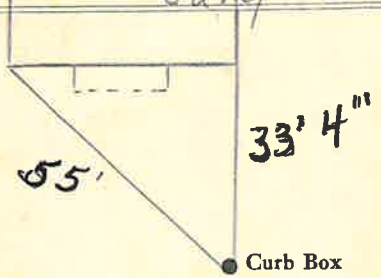

6" Main

Elev. of Main at tap 5'

Gate at •

• Gate at

15' to main  
3/4" COPPER

• Curb Box

L.M-5C-2-1-54

SANFORD

St. Pl. Ave. No. 150

150

Name of Owner

WATER INSTALLED


Labor and Mat'l. Report TO 10/15/25

A = 94' 3"

B = 94'

10' OF 3/4"

COPPER TO MAIN

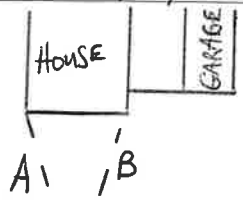


Main

Elev. of Main at tap

Gate at •

• Gate at

TAX ID# 303.9-10-19

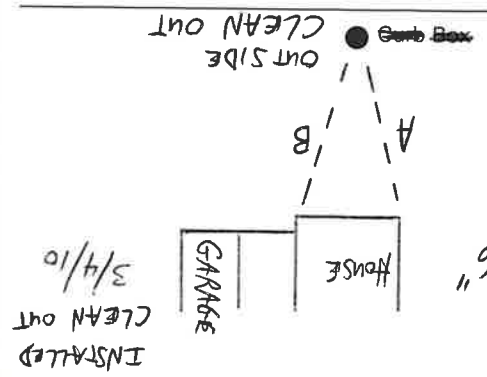

LABOR AND MATERIALS

1	Copper Lead	Connection	3/4"	\$	2.41
1	Curb	Cock Valve T.S. & V.	3/4" in.	\$	3.41
1	Service box	Short 3 1/2 x 4 1/2			
	Old returned	Long 4 1/2 x 5 1/2		\$	4.18
15	Ft. 3/4 in.	Copper Pipe at	40	\$	6.00
		G.I.			
		G.I.			
	Nipples	in. at		\$	
	Bushings	to in. at		\$	
	Red'g Inc'g	Coupl'gs to in. at		\$	
	Union	in. at		\$	
	Meter	in. at		\$	
	Lead Joints	at		\$	
	Compound Joints	at		\$	
	Maintenance Foreman			\$	9.48
	Hrs. Water Maint. Man-1	at		\$	
4	Hrs. Water Maint. Man-2	at 1.24		\$	4.96
	Hrs. Garage Foreman	at		\$	
4	Hrs. Labor	at 1.13		\$	4.52
	Hrs. Compressor	at		\$	
	Compensation Ins. at \$3.861 per C			\$	37
	Trucking			\$	5.10
	Pav't Patch			\$	13.50
				\$	
				\$	
	O'head			\$	
				\$	58.04


Tap by Giffard 7-6-54

27.35

St. PL. Ave. No. 150

SANFORD

WATER INSTALLED  
Labor and Mat'l. Report 10/15/25

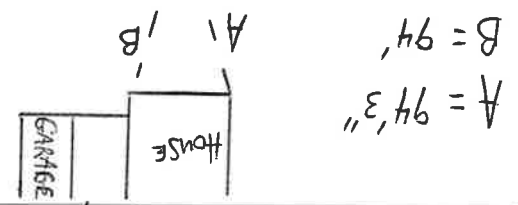

Gate at ●  
Elev. of Main at tap  
COPPER TO MAIN  
10' OF 3/4" CURB BOX

TAX ID # 303.9-10-19

OUTSIDE CLEAN OUT



INSTALLED  
CLEAN OUT  
3/4/10

