

LABOR AND MATERIALS

1	Copper	Connection	<u>3/4</u>		\$ 2.87
	Lead				
1	Curb	Cock Valve	<u>3/4</u>	in.	\$ 3.62
		T. S. & V.			
1	Service box	Short $3\frac{1}{2} \times 4\frac{1}{2}$			\$ 4.68
	Old returned	Long $4\frac{1}{2} \times 5\frac{1}{2}$			
		Buff or Rdway			
9	Ft.	Copper	<u>3/4</u>	Pipe at	\$ 2.88
		G. I.			
		C. I.			
	Nipples	in. at			\$
	Bushings	to in. at			\$
	Red'g				\$
	Inc'g	Coupl'gs to in. at			\$
	Union	in. at			\$
	Meter	in. at			\$
	Lead Joints	at			\$
	Compound Joints	at			\$
2	Hrs. Water Maint. Man-1	at	<u>1.12</u>		\$ 2.24
	Hrs. Water Maint. Man-2	at			\$
7	Hrs. Labor	at	<u>.91</u>		\$ 6.37
	Hrs. Labor	at			\$
	Hrs. Compressor	at			\$
	Compensation Ins.	at \$ 2.18 per C.			\$ 2.19
	Trucking				\$ 10.25
	Pav't Patch				\$
	<i>Top by Miller</i>				\$
	O'head				\$ 35.10

28

St.
Pl.
Ave. No. 156


Sanford

Name of Owner

Dufour

Labor and Mat'l. Report

May 17 1949

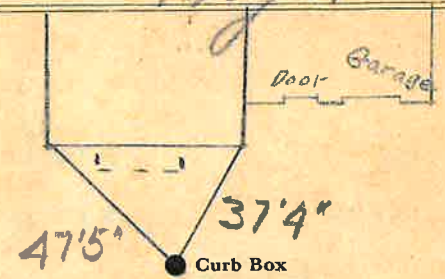

6 Main

Elev. of Main at tap 5

Gate at ●

● Gate at

TAX ID # 303.9-10-21

● Curb Box

9' to main
3/4" copper