


LABOR AND MATERIALS

1 Copper } Connection ^{3/4"} \$ _____
~~Lead~~ }
 1 Curb } Cook Valve } ^{3/4"} in. \$ _____
 } T. S. & V. }
 1 Service box { Short 3 1/2 x 4 1/2 }
 Old returned { Long 4 1/2 x 5 1/2 }
 } Buff or Rdway } \$ _____
 24 ³/₄ in. { Copper } Pipe at \$ _____
 } G. I. }
 } C. I. }
 Nipples in. at \$ _____
 Bushings to in. at \$ _____
 Red'g }
 Inc'g } Coupl'gs to in. at \$ _____
 Union in. at \$ _____
 Meter in. at \$ _____
 Lead Joints at \$ _____
 Compound Joints at \$ _____
 Maintenance Foreman \$ _____
 Hrs. Water Maint. Man-1 at \$ _____
 Hrs. Water Maint. Man-2 at \$ _____
 Hrs. Garage Foreman at \$ _____
 Hrs. Labor at \$ _____
 Hrs. Compressor at \$ _____
 Compensation Ins. at \$ _____ per C \$ _____
 Trucking \$ _____
 Pav't Patch \$ _____
 Tap by Gifford & Co. \$ _____
 10-17-58 \$ _____
 O'head \$ _____
 \$ _____
 \$ _____

✓
 Sanford St. No. 157
 Ave. No.

Name of Owner Mac Naughton

Labor and Mat'l. Report Oct. 17 19 58

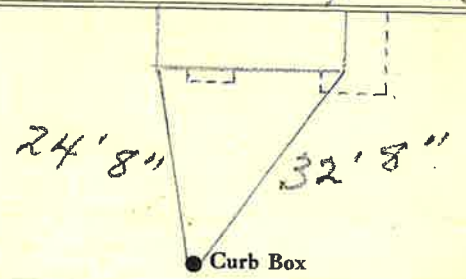

6" Main Elev. of Main at tap 5 1/2'
 Gate at • Gate at

TAX ID # 303.9-13-4

• Curb Box
 24' to main
 3/4" COPPER