


Labor and Materials

/	Copper	}	Connection.....	\$	
	Lead				
/	Curb	{	Cock Valve		
			T. S. & V.		
			in.....	\$	
/	Service Box	{	Short 3 1/2 x 4 1/2		
	Old returned		Long 4 1/2 x 5 1/2		
			Buff. or Rdway		
			at.....	\$	
2.8	Ft. 3/4	in.	{ Copper		
			Galv. Iron		
			Cast Iron		
			Pipe at.....	\$	
	Nipples		in. at.....	\$	
	Bushings		to..... in. at.....	\$	
	Red'g	{	Couplings..... to.....		
	Inc'g		in. at.....	\$	
	Union		in. at.....	\$	
	Meter		in. at.....	\$	
	Lbs. Br. Stone		at.....	\$	
	Lbs. Sand		at.....	\$	
	Bags Cement		at.....	\$	
	Paving Brick	{	Mack		
			Red		
			Asphalt		
			at.....	\$	
	Lead Joints		at.....	\$	
	Leadite Joints		at.....	\$	
	Hrs. Foreman		at.....	\$	
1.4	Hrs. Common Labor		at.....	\$	
	Hrs. Common Labor		at.....	\$	
	Hrs. Mason		at.....	\$	
	Hrs. Mason's Helper		at.....	\$	
	Hrs. Compressor		at.....	\$	
	Compensation Ins.		\$	
/	Trucking		\$	
3.0	Builders' Use of Water		\$	
Total \$.....				\$	

Labor and Material Report

1920

159

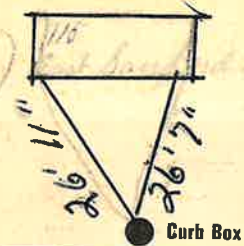

6' Main Elev. of Main at tap 4 1/2'

Gate at TAX ID # 303.9-13-3 Gate at

● Curb Box

28' to MAIN

3/4" COPPER