

LABOR AND MATERIALS

1	Copper Lead	Connection	3/4"			\$ 2.76
1	Curb	Cock Valve T. S. & V.	3/4 in.			\$ 3.49
1	Service box Old returned	Short 3 1/2 X 4 1/2 Long 4 1/2 X 5 1/2 Buff or Rdway				\$ 4.74
13	Ft.	3/4 in. Copper G.I. C.I.	Pipe at	38		\$ 4.94
	Nipples	in. at				\$
	Bushings	to in. at				\$
	Inc'g	Red'g Coupl'gs	to in. at			\$
	Union	in. at				\$
	Meter	in. at				\$
	Lead Joints	at				\$
	Compound Joints	at				\$
	Hrs. Water Maint. Man—1	at				\$
2	Hrs. Water Maint. Man—2	at	1.24			\$ 2.48
	Hrs. Labor—	at				\$
	Hrs. Labor—	at				\$
	Hrs. Compressor	at				\$
	Compensation Ins.	at \$4.406 per C				\$ 11
	Trucking					\$ 1.00
	Pav't Patch					\$ 1.485
	Tap by Giffard	9-22-53				\$
	O'head					\$
						\$34.37


19.52

21-53

St. Sanford
-Pl.
Ave. No. 160

Name of Owner Cybulski

Labor and Mat'l. Report Sept. 22 1953

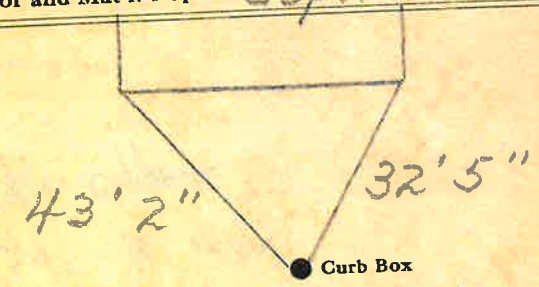

6" Main

Elev. of Main at tap 5'

Gate at ● Gate at ●

TAX ID # 303.9-10-22

● Curb Box

13' to main
3/4" COPPER