

LABOR AND MATERIALS


1	Copper Lead	Connection	3/4"	\$ 3.08
1	Curb	Cock Valve F.S. & V.	3/4 in.	\$ 3.89
1	Service box - Old returned	Short 3 1/2 x 4 1/2 Long 4 1/2 x 5 1/2 Buff or Rdway		\$ 4.32
26 Ft.	3/4 in.	Copper C.I. C.I.	Pipe at	45 \$ 11.70
	Nipples	in. at		\$
	Bushings	to in. at		\$
	Red'g Inc'g	Coupl'gs to in. at		\$
	Union	in. at		\$
	Meter	in. at		\$
	Lead Joints	at		\$
	Compound Joints	at		\$
	Maintenance Foreman			\$
	Hrs. Water Maint. Man-1	at		\$
8	Hrs. Water Maint. Man-2	at 1.613		\$ 12.90
1 1/2	Hrs. Garage Foreman	at 2.033		\$ 3.05
15	Hrs. Labor-	at 1.30		\$ 19.50
	Hrs. Compressor	at		\$
	Compensation Ins.	at \$ 5.686 per C.		\$ 2.02
	Trucking			\$ 1.50
	Pav't Patch			\$ 20.10
	Tap by Gifford & Co			\$
	11-7-56			\$
	O'head			\$
				\$ 47.06

6196

St. Sanford Ave. No. 161

Name of Owner Leon Blair

Labor and Mat'l. Report Nov. 7 1956

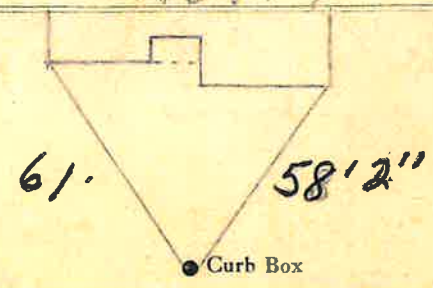

6" Main Elev. of Main at tap 5'

Gate at • Gate at •

• Curb Box

26' to MAIN  
3/4" COPPER