

LABOR AND MATERIALS


1	Copper	Connection	3/4"	\$ 2.27
	Lead			
1	Curb	Cock Valve T. S. & V.	3/4" in.	\$ 2.70
1	Service box	Short 3 1/2 x 4 1/2 Long 4 1/2 x 5 1/2 Buff or Rdway		\$ 4.25
	Old returned			
9	Ft. 3/4 in.			
	Nipples	in. at		\$
	Bushings	to in. at		\$
	Red'g	Copl'gs	to in. at	\$
	Inc'g			
	Union	in. at		\$
	Meter	in. at		\$
	Lead Joints	at		\$
	Compound Joints	at		\$
	Hrs. Water Maint. Man-1	at		\$
4	Hrs. Water Maint. Man-2	at 102		\$ 4.08
15	Hrs. Labor	at 91		\$ 13.65
	Hrs. Labor	at		\$
	Hrs. Compressor	at		\$
	Compensation Ins.	at \$2.22 per C.		\$ 39
	Trucking			\$ 1.00
	Pav't Patch			\$ 8.10
	Tap by Moquin			\$
	O'head			\$
				\$ 39.59

225-1250

St. Sanford
Flr
Ave. No. 166

Name of Owner Stark

Labor and Mat'l. Report Nov. 22 1950

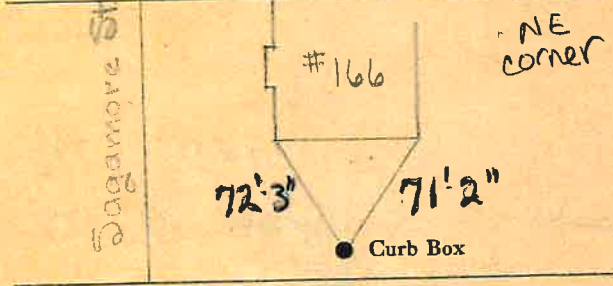

Sanford St
Elev. of Main at tap 5'
6" Main
Gate at 63 Sagamore Gate at

TAX ID # 303.9-11-12

• Curb Box
TAP ON SANFORD ST.
9' TO MAIN
3/4" COPPER