

LABOR AND MATERIALS

1	Copper	{ Connection	3/4"		\$ 2.79
	Lead				
1	Curb	{ Cock Valve T.S. & V.	3/4 in.		\$ 2.70
1	Service box	{ Short 3 1/2 x 4 1/2 Long 4 1/2 x 5 1/2 Buff or Rdway			\$ 4.25
	Old returned				
12	Ft.	{ Copper C.I. C.I.	Pipe at	35	\$ 4.20
	Nipples	in. at			\$
	Bushings	to in. at			\$
	Red'g	{ Coupl'gs to	in. at		\$
	Inc'g				\$
	Union	in. at			\$
	Meter	in. at			\$
	Lead Joints at				\$
	Compound Joints at				\$
	Hrs. Water Maint. Man-1 at				\$
2	Hrs. Water Maint. Man-2 at	1.02			\$ 2.04
12	Hrs. Labor— at	91			\$ 10.92
	Hrs. Labor— at				\$
	Hrs. Compressor at				\$
	Compensation Ins. at \$	per C.		29	\$
	Trucking			6.00	\$
	Pav't Patch			8.10	\$
	Tap by Moquin				\$
					\$
					\$
	O'head				\$
					\$ 35.77

191-1950

Sanford


St. Pt. Ave. No. 170

Name of Owner

Ferguson

Labor and Mat'l. Report

Sept 15 1950

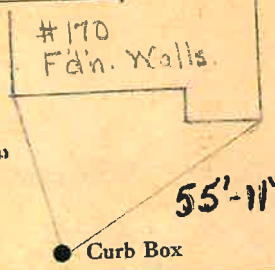

6" Main

Elev. of Main at tap 3 1/2'

Gate at •

• Gate at

TAX ID # 303.9-11-13

• Curb Box

12' to main
3/4" copper