


Labor and Materials

1. Copper	Connection ^{3/4"}	\$ 1.33
1. Lead		
1. Curb	{ Cock Valve } ^{3/4" in}	\$ 1.58
	{ T.S. & V. }	
1. Service Box	{ Short ^{3 1/2 x 4 1/2}	\$ 1.36
Old returned	{ Long ^{4 1/2 x 5 1/2}	
	{ Buff. or Rdway }	
29 ft. ^{3/4"} in.	{ Copper Galv. Iron } Pipe at	\$ 2.09
	{ Cast Iron }	
Nipples	in. at	\$
Bushings	to in. at	\$
Red'g Inc'g	{ Couplings } to in. at	\$
Union	in. at	\$
Meter	in. at	\$
Lbs. Br. Stone	at	\$
Lbs. Sand	at	\$
Bags Cement	at	\$
Paving Brick	{ Mack Red Asphalt } at	\$
Lead Joints	at	\$
Leadite Joints	at	\$
16 Hrs. Foreman	at	\$ 10.00
5 Hrs. Common Labor	at	\$ 2.50
4 Hrs. Common Labor	at	\$ 3.60
Hrs. Mason	at	\$
Hrs. Masons Helper	at	\$
Hrs. Compressor	at	\$ 4.90
Compensation Ins		\$
Trucking		\$
Builders Use of Water	Patch	\$ 5.00
Total		\$ 28.95

33-87

Labor and Material Report Nov 24 1933

3/4 Renewell at ¹⁷¹ Sanford st

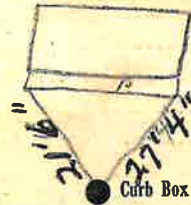

6" Main Elev. of Main at tap 41

Gate at • TAX ID # 303.9-14-4 • Gate at

● Curb Box

Old tap shut off at main

No taping card made out for this tap.

O.K. G/H

22' to main

3/4" copper