

LABOR AND MATERIALS

1	Copper Lead	Connection $\frac{3}{4}$	\$ 1.43
1	Curb	{ Cock Valve T. S. & V. } $\frac{3}{4}$ in.	\$ 1.88
1	Service Box Old returned	{ Short $3\frac{1}{2} \times 4\frac{1}{2}$ Long $4\frac{1}{2} \times 5\frac{1}{2}$ Buff. or Rdway }	\$ 1.75
12	Ft. $\frac{3}{4}$ in.	{ Copper Galv. Iron Cast Iron } Pipe at	\$ 2.16
	Nipples	in. at	\$
	Bushings	to in. at	\$
	Red'g Inc'g	{ Couplings to in. at	\$
	Union	in. at	\$
	Meter	in. at	\$
	Lead Joints	at	\$
	Leadite Joints	at	\$
	Hrs. Foreman	at	\$
2	Hrs. Chauffeur	at $62\frac{1}{2}$	\$ 1.25
4	Hrs. Tapper	at	\$ 2.50
4	Hrs. Labor	at $45$	\$ 1.80
	Hrs. Labor	at	\$
	Hrs. Compressor	at	\$
	Compensation Ins.		\$ .17
	Trucking		\$ 1.00
	Builders Use of Water		\$
	<i>Tap by Hand</i>		\$
	$\frac{1}{2}$ of Patch (Sewer also)		\$ 2.50
			\$
			\$
			\$ 16.44

1 0 1938

St.

Pl.

Ave. No. 177


Name of Owner

*Beane*

Labor and Mat'l. Report

*April 7*

1938

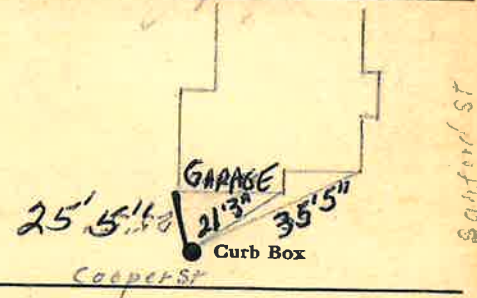

6 Main

Elev. of Main at tap  $4\frac{1}{2}$

Gate at ●

● Gate at

TAX ID # 303.9-14-1

12' to main  
3/4" copper

● Curb Box

NEW HOUSE

This Tap is on Cooper St.  
*New House*