

LABOR AND MATERIALS

1	Copper Lead	Connection	3/4"	\$	2.41
1	Curb	Cock Valve F.S. & V.	3/4" in.	\$	3.91
1	Service box	Short 3 1/2 x 4 1/2			
	Old returned	Long 4 1/2 x 5 1/2			
		Buff or Rdway		\$	4.18
28	3/4 in.	Copper Pipe at	40	\$	11.20
		C.I.			
		C.I.			
	Nipples	in. at		\$	
	Bushings	to in. at		\$	
	Red'g Inc'g	Coupl'gs to in. at		\$	
	Union	in. at		\$	
	Meter	in. at		\$	
	Lead Joints at			\$	
	Compound Joints at			\$	
	Maintenance Foreman			\$	
	Hrs. Water Maint. Man	1 at		\$	
6	Hrs. Water Maint. Man	2 at 1.24		\$	7.44
	Hrs. Garage Foreman	at		\$	
12	Hrs. Labor	at 1.13		\$	13.56
	Hrs. Compressor at			\$	
	Compensation Ins. at	\$3.861 per C		\$	91
	Trucking			\$	1.50
	Pav't Patch			\$	17.55
	Tap by Gissold	9-20-54		\$	
	O'head			\$	
				\$	62.06

11457


2100

69-54

St. Sangard
 Ave. No. 178

Name of Owner A. Hay

Labor and Mat'l. Report Sept. 20 19 54

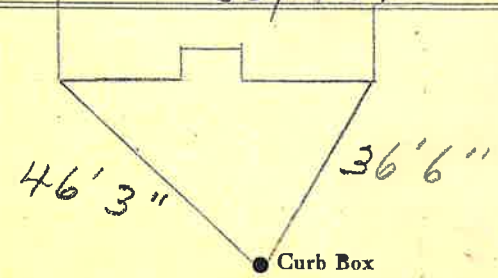

12" Main Elev. of Main at tap 5'
 Gate at • Gate at

TAX ID # 303.9-11-16

• Curb Box
 Tap on Mauro Ave.
 28" to main
 3/4" copper