

## LABOR AND MATERIALS

1	Copper	Connection	$\frac{3}{4}$ "		\$
	<del>Lead</del>				
1	Curb	Cock Valve	$\frac{3}{4}$ "	in.	\$
		P. S. & V.			
1	Service box	Short $3\frac{1}{2}$ " X $4\frac{1}{2}$ "			\$
	Old returned	Long $4\frac{1}{2}$ " X $5\frac{1}{2}$ "			\$
		Buff or Rdway			\$
23	Ft.	Copper	$\frac{3}{4}$ "	Pipe at	\$
		G. I.			\$
		G. I.			\$
	Nipples	in.		at	\$
	Bushings	to		in. at	\$
	Red'g				\$
	Inc'g	Coupl'gs	to	in. at	\$
	Union	in.		at	\$
	Meter	in.		at	\$
	Lead Joints	at			\$
	Compound Joints	at			\$
	Hrs. Water Maint. Man-1	at			\$
	Hrs. Water Maint. Man-2	at			\$
	Hrs. Labor	at			\$
	Hrs. Labor	at			\$
	Hrs. Compressor	at			\$
	Compensation Ins.	at \$		per C	\$
	Trucking				\$
	Pav't Patch				\$
	Lareau, J. Tipp.				\$
	O'head				\$
					\$


Sanford

St. \_\_\_\_\_  
 Pr. \_\_\_\_\_  
 Ave. No. 183

Name of Owner \_\_\_\_\_

Measured in Mar. 17

Labor and Mat'l. Report 1954

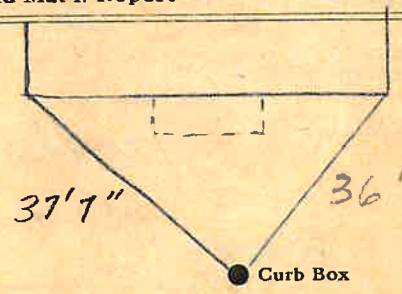

25  $\frac{3}{4}$  To MAIN

12" Main Elev. of Main at tap 5'

Gate at Gate at

#183

TAX ID # 303.9-15-4

● Curb Box

25' to MAIN  
 $\frac{3}{4}$ " COPPER