


SARELLA St. Pl. Ave. No. 7

Name of Owner John McCormick

Labor and Mat'l. Report June 29 1977

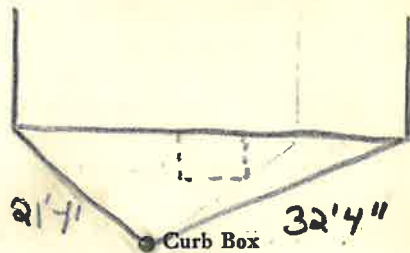

4 Main Elev. of Main at tap 6

Gate at • Gate at

• Curb Box


Check Measurements

LSM-5C-6-1-67

Sarella St. Pl. Ave. No. 7

Name of Owner John McCormick

Labor and Mat'l. Report June 27 1977

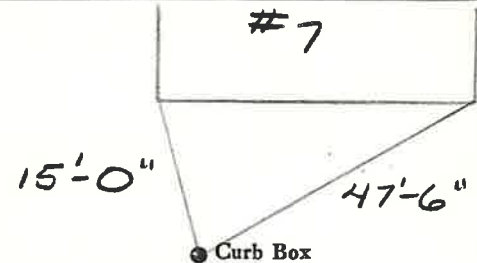

4" Main Elev. of Main at tap 5'

Gate at • Gate at

• Curb Box

TAX ID # 302.12-26-6

27' to MAIN
3/4" COPPER

LSM-5C-6-1-67

✓

LABOR AND MATERIALS

	Copper Lead	Connection	$\frac{3}{4}$ "		\$
1	Curb	Cock Valve T.S. & V.	$\frac{3}{4}$ in.		\$
1	Service box Old returned	Short $3\frac{1}{2} \times 4\frac{1}{2}$ Long $4\frac{1}{2} \times 5\frac{1}{2}$ Buff or Rdway			\$
	Ft. in.	Copper G.I. C.I.	Pipe at $\frac{3}{4}$ " Copper		\$
	Nipples	in. at			\$
	Bushings	to in. at			\$
	Red'g Inc'g	Coupl'gs	to in. at		\$
	Union	in. at			\$
	Meter	in. at			\$
	Lead Joints	at			\$
	Compound Joints	at			\$
	Maintenance Foreman				\$
	Hrs. Water Maint. Man—1	at			\$
	Hrs. Water Maint. Man—2	at			\$
	Hrs. Garage Foreman	at			\$
	Hrs. Labor—	at			\$
	Hrs. Compressor	at			\$
	Compensation Ins. at \$	per C			\$
	Trucking				\$
	Pav't Patch				\$
					\$
					\$
	O'head				\$
					\$

LABOR AND MATERIALS

	Copper Lead	Connection	$\frac{3}{4}$ in		\$
1	Curb	Cock Valve T.S. & V.	$\frac{3}{4}$ in.		\$
1	Service box Old returned	Short $3\frac{1}{2} \times 4\frac{1}{2}$ Long $4\frac{1}{2} \times 5\frac{1}{2}$ Buff or Rdway			\$
	27 Ft.	$\frac{3}{4}$ in.	Copper G.I. C.I.	Pipe at	\$
	Nipples	in. at			\$
	Bushings	to in. at			\$
	Red'g Inc'g	Coupl'gs	to in. at		\$
	Union	in. at			\$
	Meter	in. at			\$
	Lead Joints	at			\$
	Compound Joints	at			\$
	Maintenance Foreman				\$
	Hrs. Water Maint. Man—1	at			\$
	Hrs. Water Maint. Man—2	at			\$
	Hrs. Garage Foreman	at			\$
	Hrs. Labor—	at			\$
	Hrs. Compressor	at			\$
	Compensation Ins. at \$	per C			\$
	Trucking				\$
	Pav't Patch				\$
					\$
					\$
	O'head				\$
					\$

Tap by Beecher
+ Co. June 27, 1978

LABOR AND MATERIALS

Copper	}	Connection	\$
Lead			\$
Curb	}	in.	\$
Cock Valve			\$
T. S. & V.			\$
Service box	}	Short $3\frac{1}{2} \times 4\frac{1}{2}$	\$
Old returned		Long $4\frac{1}{2} \times 5\frac{1}{2}$	\$
		Buff or Rdway	\$
Ft. in.	}	Pipe at	\$
Copper			\$
G. I. C. I.			\$
Nipples	in. at		\$
Bushings	to in. at		\$
Red'g	}	Coupl'gs to in. at	\$
Inc'g			\$
Union	in. at		\$
Meter	in. at		\$
Lead Joints	at		\$
Compound Joints	at		\$
Hrs. Water Maint. Man	— 1 at		\$
Hrs. Water Maint. Man	— 2 at		\$
Hrs. Labor	at		\$
Hrs. Labor	at		\$
Hrs. Compressor	at		\$
Compensation Ins.	at \$ per C.		\$
Trucking			\$
Pav't Patch			\$
			\$
			\$
			\$
O'head			\$
			\$

Sarella

St. ~~St.~~ 7
Ave. No.

Name of Owner
Upholstery Shop

Labor and Mat'l. Report *Jan 28* 1952

#9

#7

21'-5" 14'-7"

● Curb Box

Main

Elev. of Main at tap

Gate at ●

● Gate at

● Curb Box

LSM-5C 10-21-49