


Labor and Materials

1...Copper } Connection. 3/4"	\$ 1.33
1...Lead } Connection. 3/4"	
1...Curb { Cock Valve T.S.&V. } 3/4" in	\$ 1.58
1...Service Box { Short 3 1/2 x 4 1/2 Long 4 1/2 x 5 1/2 } Old returned Buff. or Rawb.	\$ 1.36
11 Ft. 3/4 in. { Copper Galv. Iron Cast Iron } Pipe at	\$ 1.04
Nipples in. at	\$ .05
1...Bushings 3/4" to 1/2" in. at	\$ .05
Red'g Inc'g } Couplings.....to.....in.at	\$ .05
Union.....in. at	\$ .
Meter.....in. at	\$ .
Lbs. Br. Stone at	\$ .
Lbs. Sand at	\$ .
Bags Cement at	\$ .
Paving Brick { Mack Red Asphalt } at	\$ .
Lead Joints at	\$ .
Leadite Joints at	\$ .
9...Hrs. Foreman at	\$ 5.63
4...Hrs. Common Labor at <i>Tapper</i>	\$ 2.00
Hrs. Common Labor at	\$ .
Hrs. Mason at	\$ .
Hrs. Mason's Helper at	\$ .
Hrs. Compressor at	\$ .
Compensation Ins	\$ .24
Trucking	\$ 1.00
Builders Use of Water Patch	\$ 5.00

Total \$19.23

3/4 tap at b. Sarnella at

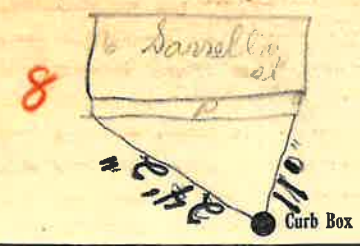

4" Main Elev. of Main at tap 4 1/2"

Gate at TAX ID # 302.12-18-14 Gate at

● Curb Box

Old tap shut off

OFF POSITION IS ACTUALLY "ON". KH 6-4-2003

O.I.S., etc.  
11' to MAIN  
3/4" COPPER

7M