

Labor and Materials

1. Copper } Connection. $\frac{3}{4}$ "	\$ 3.20
1. Curb { Cock } $\frac{3}{4}$ " in.	\$ 1.00
1. Service Box { Short 3 1/2 x 4 1/2 } Old returned { Long 4 x 5 1/2 } Buff. or Relay	\$ 1.30
8. Ft. $\frac{3}{4}$ " in. Copper } Pipe at 22	\$ 1.26
1. Nipples. $\frac{3}{4}$ " in. at.	\$.12
Bushings..... to..... in. at.....	\$
1. Inc'g } Couplings... 1" to $\frac{3}{4}$ " in. at	\$.15
Union..... in. at.....	\$
Meter..... in. at.....	\$
Lbs. Br. Stone at.....	\$
Lbs. Sand at.....	\$
Bags Cement at.....	\$
Paving Brick { Mack } Red } at	\$
Asphalt }	\$
Lead Joints at.....	\$
Leadite Joints at.....	\$
Hrs. Foreman at.....	\$
7. Hrs. Common Labor at 50	\$ 3.50
5. Hrs. Common Labor at 40.50	\$ 2.03
Hrs. Mason at.....	\$
Hrs. Mason's Helper at.....	\$
Hrs. Compressor at.....	\$
Compensation Ins.....	\$ 1.6
Trucking.....	\$ 1.00
Builders' Use of Water.....	\$


Total \$14.22

26-16

10

Labor and Material Report July 9 1926

8 Soella St
NEW HOUSE + TAP

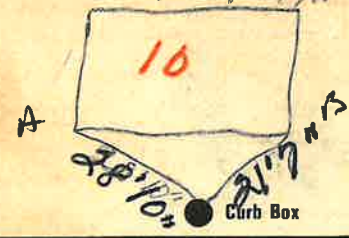

4" Main

Elev. of Main at tap 5"

Gate at ● TAX ID # 302.12-18-15 ● Gate at

OC ● Curb Box
26' from A
21' from B
New Tap
New House
8' to main
3/4" COPPER