


**Labor and Materials**

1	Copper	Connection	.....	.....	\$ 1.96
1	Curb	Cock Valve T.S.&V.	..... in	.....	\$ 1.33
1	Service Box	Short 3/4 x 4 1/2	.....	.....	\$ 1.35
	Old returned	Long 4 1/2 x 5 1/2			
27	3/4 in.	Copper Galv Iron Cast Iron	Pipe at	15	\$ 4.05
	Nipples	..... in. at	.....	.....	\$
	Bushings	..... to .....	in. at	.....	\$
	Red'g Inc'g	Couplings	..... to .....	in. at	\$
	Union	..... in. at	.....	.....	\$
	Meter	..... in. at	.....	.....	\$
	Lbs. Br. Stone	at	.....	.....	\$
	Lbs. Sand	at	.....	.....	\$
	Bags Cement	at	.....	.....	\$
	Paving Brick	Mack Red Asphalt	at	.....	\$
	Lead Joints	at	.....	.....	\$
	Leadite Joints	at	.....	.....	\$
	Hrs. Foreman	at	.....	.....	\$
	Hrs. Common Labor	at	.....	.....	\$
	Hrs. Common Labor	at	.....	.....	\$
	Hrs. Mason	at	.....	.....	\$
	Hrs. Masons Helper	at	.....	.....	\$
	Hrs. Compressor	at	.....	.....	\$
	Compensation Ins	.....	.....	.....	\$
	Trucking	.....	.....	.....	\$
	Builders Use of Water	patch	.....	.....	\$ 5-

Total \$.....

27-36 13  
 Labor and Material Report May 12 1934

13 Sarella St

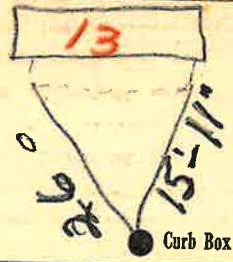

4" Main Elev of Main at tap 5 1/2

Gate at TAX ID # 302.12-26-3 Gate at

● Curb Box

Old tap disconnected  
 27' to main  
 3/4" COPPER