

# LABOR AND MATERIALS

Copper } Connection ..... \$  
 Lead }  
 Curb { Cock Valve } ..... in. .... \$  
       { T. S. & V. }  
 Service Box } Short 3/4x4/4 } ..... \$  
 Old returned } Long 4/4x5/4 }  
                   { Buffer Rdway }  
 9 Ft. 3/4" in. { Copper Galv Iron Cast Iron } Pipe at ..... \$  
 Nipples ..... in. at ..... \$  
 Bushings ..... to ..... in. at ..... \$  
 Red'g } Couplings ..... to ..... in. at ..... \$  
 Inc'g }  
 Union ..... in. at ..... \$  
 Meter ..... in. at ..... \$  
 Lead Joints at ..... \$  
 Leadite Joints at ..... \$  
 Hrs. Foreman at ..... \$  
 Hrs. Chauffeur at ..... \$  
 Hrs. Tapper at ..... \$  
 Hrs. Labor at ..... \$  
 Hrs. Labor at ..... \$  
 Hrs. Compressor at ..... \$  
 Compensation Ins. .... \$  
 Trucking ..... \$  
 Builders Use of Water ..... \$  
 ..... \$  
 ..... \$  
 ..... \$


St. **14**  
 Pl. **12**  
 Ave. No. **12**

Sorella

Name of Owner

Labor and Mat'l. Report

Mar 6 1942

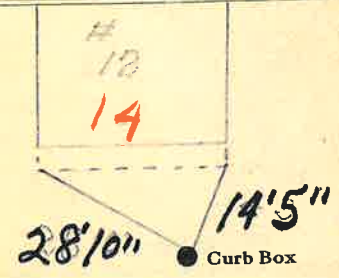

4" Main

Elev. of Main at tap

Gate at ● Gate at ●

TAX ID # 302.12-18-17

● Curb Box

NEW SERVICE - SEPT. 1, 2000

9' to main  
 3/4" COPPER

#14 is on this tap