


Labor and Materials

1	Copper	Connection	2	\$ 1.50	
1	Curb	Cock Valve	1	\$ 1.70	
1	Service Box	Short 3 1/2 x 4 1/2			
	Old returned	Long 4 1/2 x 5 1/2		\$ 1.50	
9	Ft.	Copper Galv. Iron Cast Iron	in.	Pipe at \$ 1.71	
	Nipples	in.	at	\$	
	Bushings	to	in.	at \$	
	Red'g Inc'g	Couplings	to	in.	at \$
	Union	in.	at	\$	
	Meter	in.	at	\$	
	Lbs. Br. Stone	at		\$	
	Lbs. Sand	at		\$	
	Bags Cement	at		\$	
	Paving Brick	Mack Red Asphalt	at	\$	
	Lead Joints	at		\$	
	Leadite Joints	at		\$	
3	Hrs. Foreman	at	6 2/2	\$ 1.88	
	Hrs. Common Labor	at		\$	
	Hrs. Mason	at		\$	
	Hrs. Masons Helper	at		\$	
	Hrs. Compressor	at		\$	
	Compensation Ins			\$ 9.07	
	Trucking			\$ 1-	
	Builders Use of Water			\$	

Total \$ 9.40

Sargent St

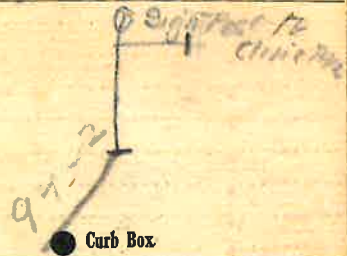

6

Main

Elev. of Main at tap 5 1/2

Gate at

Gate at

Curb Box

New Tap

Fitzgerald

9' to main
3/4" copper