

LABOR AND MATERIALS

| | | | | | |
|----|-------------------------|-----------------------|-----------|----|-------|
| 1 | Copper | { Connection | 3/4" | \$ | 3.04 |
| 1 | Lead | { | | | |
| 1 | Curb | { Cock Valve | 3/4 in. | \$ | 3.54 |
| | | { T.S. & V. | | | |
| 1 | Service box | { Short 3 1/2 x 4 1/2 | | \$ | 4.70 |
| 25 | Old returned | { Long 4 1/2 x 5 1/2 | | | |
| | | { Buff or Rdway | | | |
| 65 | Ft. | { Copper | 3/4 in. | \$ | 9.75 |
| | | { G.I. | | | |
| | | { C.I. | | | |
| | Nipples | in. at | | \$ | |
| | Bushings | to in. at | | \$ | |
| | Red'g | { Coupl'gs | to in. at | \$ | |
| | Inc'g | { | | | |
| | Union | in. at | | \$ | |
| | Meter | in. at | | \$ | |
| | Lead Joints | at | | \$ | |
| | Compound Joints | at | | \$ | |
| | Hrs. Water Maint. Man-1 | at | | \$ | |
| 3 | Hrs. Water Maint. Man-2 | at | 1.13 | \$ | 3.39 |
| 3 | Hrs. Labor | at | 1.02 | \$ | 3.06 |
| | Hrs. Labor | at | | \$ | |
| | Hrs. Compressor | at | | \$ | |
| | Compensation Ins. at \$ | per C. | | \$ | 1.17 |
| | Trucking | | | \$ | 1.17 |
| | Pav't Patch | | | \$ | |
| | O'head | | | \$ | |
| | Tap by Gifford | | | \$ | 27.65 |
| | 7-30-51 | | | | 16.00 |

118-1151


Sargent

St. PL
Aver No. 20-22

Name of Owner

Flahive

Labor and Mat'l. Report July 30 19 51

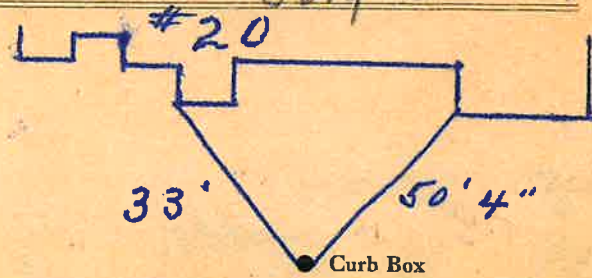

6" Main

Elev. of Main at tap 6'

Gate at #20 TAX ID # 302.8-2-45 Gate at

Queensbury

• Curb Box

25' to MAIN

3/4" copper