

Labor and Materials

1	Copper Lead	Connection	3/4"	\$	1.46
1	Carb	Cock Valve T. S. & V.	3/4" in	\$	1.93
1	Service Box Old returned	Short 3 1/2 x 4 1/2 long 4 1/2 x 5 1/2 Buff. or Rdway		\$	1.77
9	Ft. 3/4" in.	Copper Galv Iron Cast Iron	Pipe at	\$	1.98
	Nipples	in. at		\$	
	Bushings	to	in. at	\$	
	Red'g Inc'g	Conplings	to	in. at	\$
	Union	in. at		\$	
	Meter	in. at		\$	
	Lead Joints at			\$	
	Leadite Joints at			\$	
	Hrs. Foreman at			\$	
1	Hrs. Chauffeur at	6 1/2 hr		\$	0.63
	Hrs. Tapper at			\$	
	Hrs. Labor at			\$	
	Hrs. Labor at			\$	
	Hrs. Compressor at			\$	
	Compensation Ins.			\$	0.2
	Trucking			\$	1.00
	Builders Use of Water	outside no meter		\$	
				\$	
				\$	
	Miller made Tap.			\$	0.79

2-1937

St. #7
Pt.
Ave. No. 8


Sargent

Name of Owner

John Sullivan (7)

Labor and Mat'l. Report Mar 2

1937

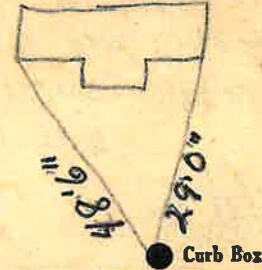

6" Main

Elev. of
Main at tap 51

Gate at

Gate at

TAX ID# 302.8-2-48

QUEENS B.U.R.Y.

Curb Box

Now House.

9' to MAIN

3/4" COPPER