


Labor and Materials

Copper	} Connection.....	3	\$ 1.25
Lead			
Curb	{ Cock Valve	4	\$ 1.70
Service Box	{ Short 3 1/2 x 4 1/2	3	\$ 1.37
On returned	{ Buff. or Raw		
8 Ft. 3/4 in.	{ Copper Galv. Iron Cast Iron	13 hrs.	\$ 1.08
Nipples	in. at		\$
Bushings	to in. at		\$
Red'g Inc'g	{ Couplings.....	to in. at	\$
Union	in. at		\$
Meter	in. at		\$
Lbs. Br. Stone	at		\$
Lbs. Sand	at		\$
Bags Cement	at		\$
Paving Brick	{ Mack Red Asphalt	at	\$
Lead Joints	at		\$
Leadite Joints	at		\$
7 Hrs. Foreman	at	6 hrs.	\$ 1.25
2 Hrs. Common Labor	at	45	\$.90
Hrs. Common Labor	at		\$
Hrs. Mason	at		\$
Hrs. Masons Helper	at		\$
Hrs. Compressor	at		\$
Compensation Ins			\$.08
Trucking			\$ 1.00
Builders Use of Water			\$

Total \$ 8.63

1935-69
Labor and Material Report July 1 1935

#9 Sargent St (15) (9)

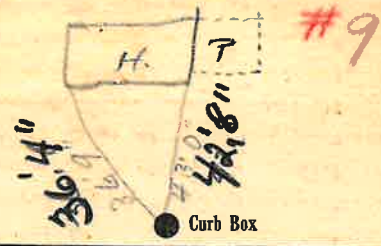

6" Main Elev. of Main at tap 4 1/2

Gate at TAX ID # 302.8-2-47 Gate at

Queensbury Curb Box

New House

8' to main
3/4" copper

AM