

LABOR AND MATERIALS

| | | | | | |
|----|-------------------------|-----------------------|--------------------|-----|----------|
| 1 | Copper Lead | Connection | 3/4 | | \$ 2.94 |
| 1 | Curb | Cock Valve T. S. & V. | 3/4 | in. | \$ 3.71 |
| 1 | Service box | Old returned | Short 3/4 X 4 1/2 | | \$ 5.90 |
| | | | Long 4 1/2 X 5 1/2 | | |
| | | | Buff or Rdway | | |
| 22 | Ft. | Copper Pipe at | 30 | | \$ 6.60 |
| | | | | | |
| | Nipples | in. at | | | \$ |
| | Bushings | to in. at | | | \$ |
| | Red'g Inc'g | Coupl'gs. to in. at | | | \$ |
| | Union | in. at | | | \$ |
| | Meter | in. at | | | \$ |
| | Lead Joints | at | | | \$ |
| | Compound Joints | at | | | \$ |
| | Hrs. Water Maint. Man-1 | at | | | \$ |
| 5 | Hrs. Water Maint. Man-2 | at | 91 | | \$ 4.55 |
| 21 | Hrs. Labor- | at | 80 | | \$ 16.80 |
| | Hrs. Labor- | at | | | \$ |
| | Hrs. Compressor | at | | | \$ |
| | Compensation Ins. | at \$ per C | | | \$ 47 |
| | Trucking | | | | \$ |
| | Pav't Patch | outside | | | \$ |
| | Tap | 1/4 in. dia | | | \$ |
| | O'head | | | | \$ 41.97 |


84

St. _____
Pl. _____
Ave. No. 12

Sargent

Name of Owner
Nathan

Labor and Mat'l. Report July 14 1948

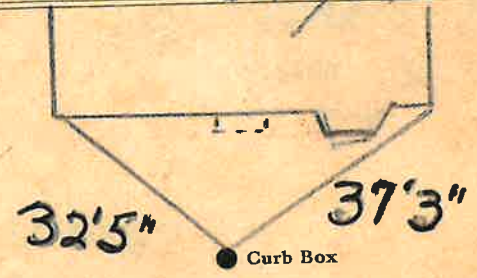

6 Main Elev. of Main at tap 4
Gate at ● Gate at ●

TAX 10# 3028-2-41
Queensbury

● Curb Box
22' to MAIN
3/4" COPPER