

Labor and Materials


1	Copper	Connection	3/4"	\$ 1.48
.....	Lead			
1	Curb	Cock Valve T.S.&V.	3/4" in	\$ 1.79
1	Service Box	Short 3 1/2 x 4 1/2		\$ 1.30
.....	Old returned	Long 4 1/2 x 5 1/2		
25	Ft.	Copper Galv. Iron Cast Iron	Pipe at	\$ 4.50
.....	Nipples	in. at		\$
.....	Bushings	to in. at		\$
.....	Red'g Inc'g	Couplings	to in. at	\$
.....	Union	in. at		\$
.....	Meter	in. at		\$
.....	Lbs. Br. Stone	at		\$
.....	Lbs. Sand	at		\$
.....	Bags Cement	at		\$
.....	Paving Brick	Mack Red Asphalt	at	\$
.....	Lead Joints	at		\$
.....	Leadite Joints	at		\$
17	Hrs. Foreman	at	band	\$ 7.50
2	Hrs. Common Labor	at	top	\$ 1.00
2	Hrs. Common Labor	at		\$ 9.00
.....	Hrs. Mason	at		\$
.....	Hrs. Masons Helper	at		\$
.....	Hrs. Compressor	at		\$
.....	Compensation Ins			\$ 2.9
.....	Trucking			\$ 1
.....	Builders Use of Water	vs. pat. (5-7)		\$

Total \$ 19.76.

# 14-13 Sargent St.

Labor and Material Report Aug 25 1922

3/4" tap per ledger Sargent St

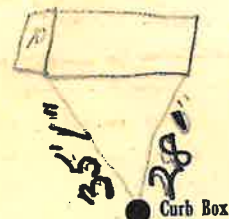

14

6" Main

Elev. of Main at tap 4.4

Gate at TAX ID # 302.8-2-42 Gate at Queensbury

● Curb Box

New House

25' to main  
3/4" copper

Q/S G/M